

**SHEET
SUBMITTED
FOR
REFERENCE
IN JOC1 AND
JOC3**

**Peoria Sports Complex - Stadium
Improvements JOC Package 2**

16101 North 83rd Avenue
Peoria, AZ 85382


1319.02

DFDG PROJECT NUMBER

RECORD DRAWINGS
**SPECIAL EVENT
FIELD EGRESS**

G102

PLOT DATE: 4/11/2015 3:19:09 AM SHEET NUMBER

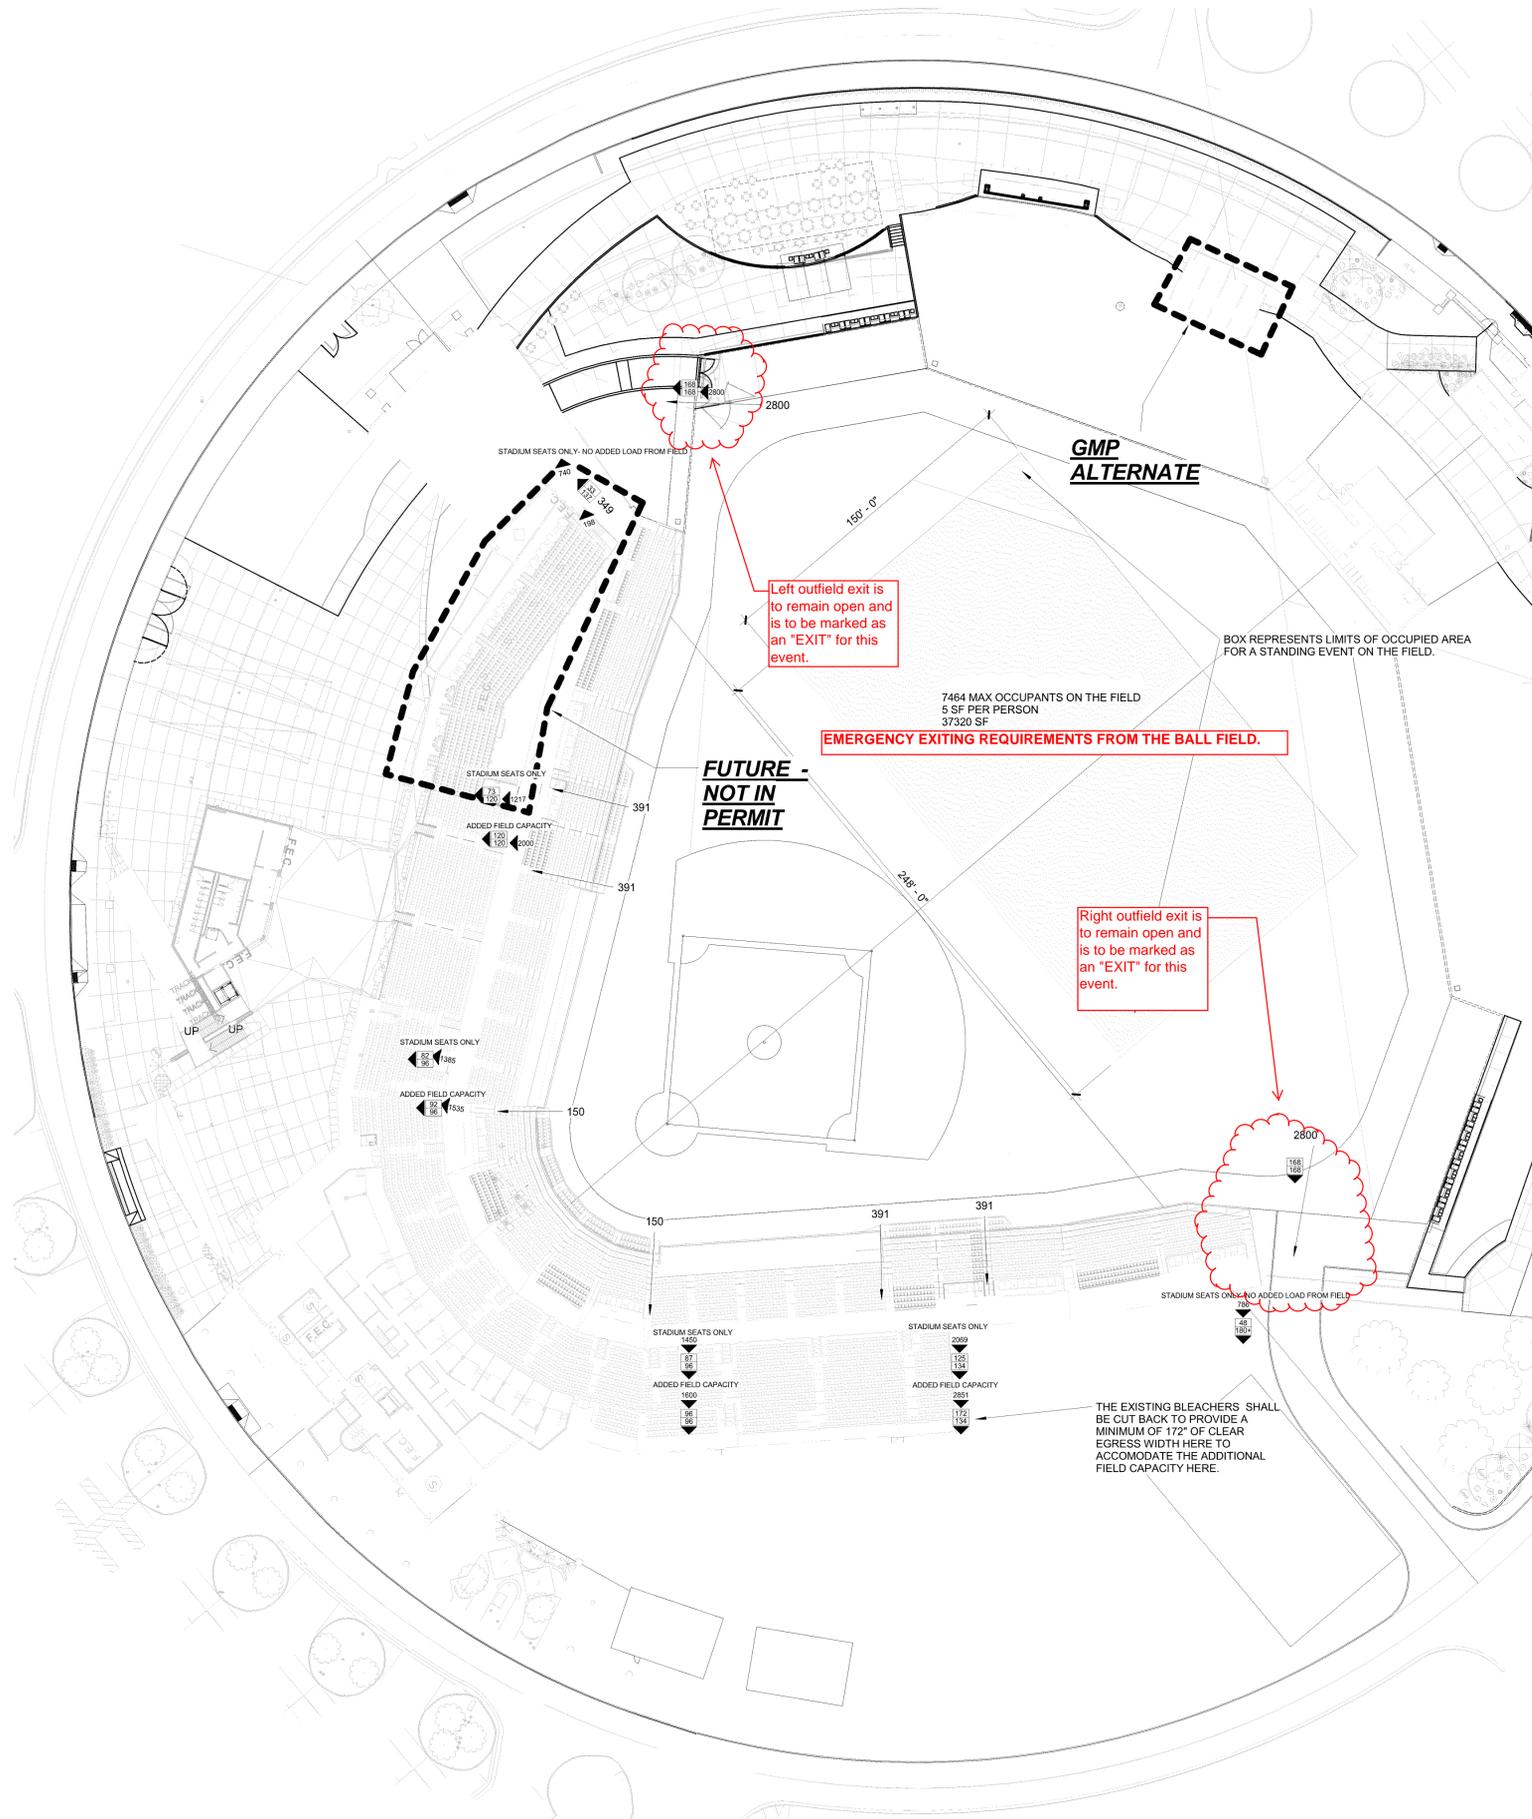

- FIELD EXITING CAPACITY ASSUMES THE FOLLOWING:**
1. ANY CHAIRS ARE ADEQUATELY CONNECTED TO EACH OTHER PER ASSEMBLY CODE REQUIREMENTS IN ARRANGEMENTS PROVIDING ADEQUATE EGRESS WIDTHS.
 2. EXITS ARE CLEARLY MARKED DURING AN EVENT
 3. THE EXISTING RAIL AT THE SOUTHEAST GATE HAS BEEN ADJUSTED TO PROVIDE A FLUSH FLOOR AT THE EXITING PATH
 4. STAFF IS DIRECTING TRAFFIC DURING AN EVENT
 5. ALL PROPOSED SEATING ARRANGEMENTS AND EXITING DIAGRAMS SHOULD BE REVIEWED BY THE AHJ BEFORE EACH EVENT
 6. THE FIRE DEPARTMENT IS MONITORING THE EVENT AND CROWD SIZE ON THE FIELD TO BE WITHIN THE LIMITS OF THE MAX OCCUPIED AREA SHOWN.

TOTAL CAPACITY OF FIELD WITH EGRESS AS INDICATED= **7464 OCCUPANTS**

1 SPECIAL EVENT FIELD MAX OCCUPANCY EXHIBIT
1" = 40'-0"

